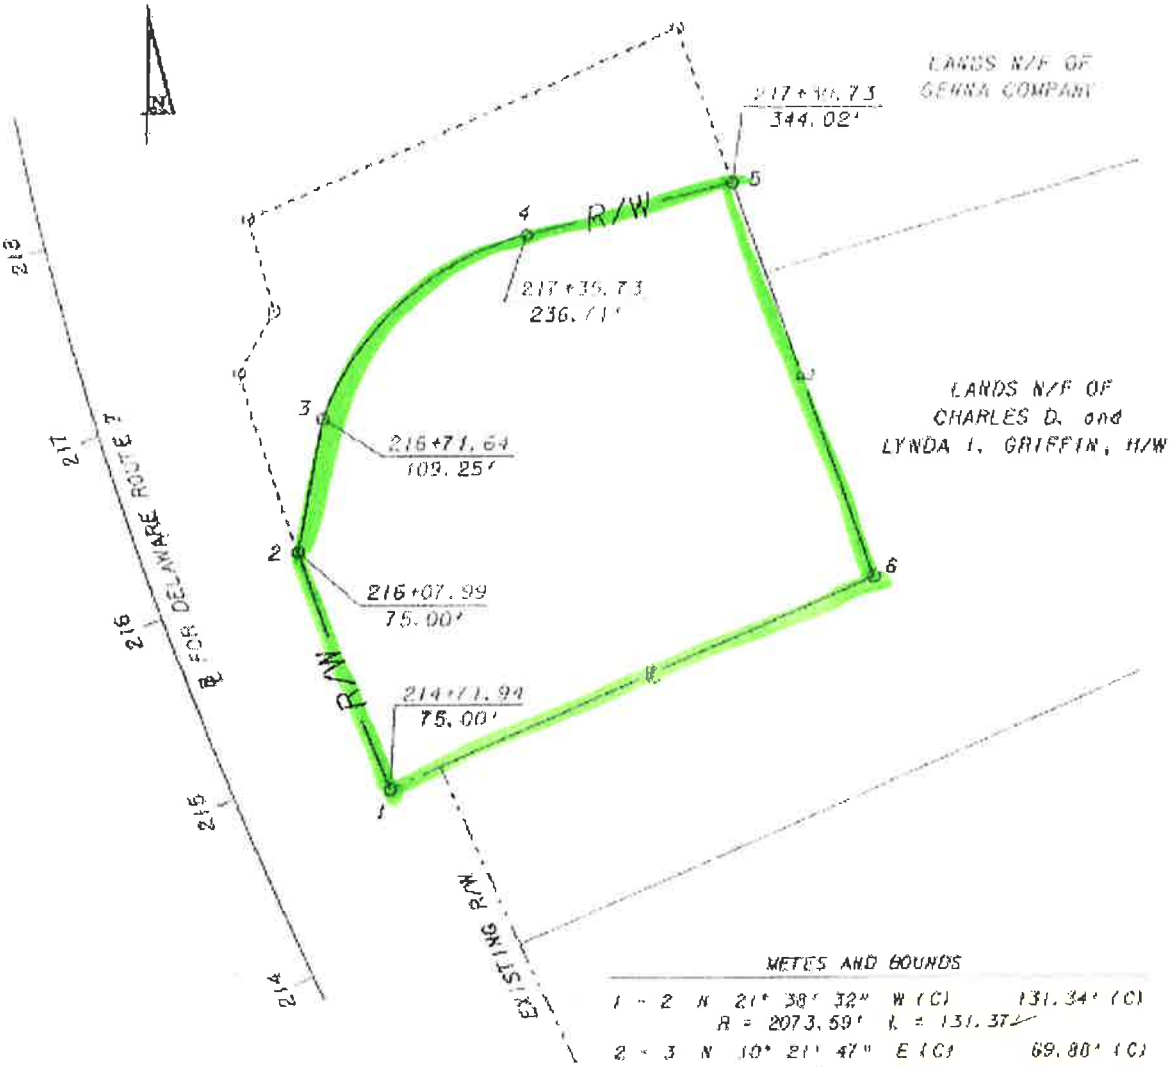

METES AND BOUNDS

1 - 2	N	21° 38' 32"	W (C)	131.34' (C)	
	R = 2073.59'	L = 131.37			
2 - 3	N	10° 21' 47"	E (C)	69.80' (C)	
3 - 4	N	47° 54' 41"	E (C)	140.41' (C)	
	R = 150.00'	L = 146.12			
4 - 5	N	75° 49' 06"	E (C)	107.39' (C)	
5 - 6	S	19° 47' 02"	E (D)	216.09' (D)	? 216.07
6 - 1	S	66° 16' 38"	W (D)	268.51' (D)	

AREA = ~~1.352~~ 1.347 +/- AC.

JEFFREY A. KANE and CAROLYN H. KANE, H/W
LANDS PROCURED FROM

NEW CASTLE COUNTY	MILL CREEK HUNDRED	~~08-030.00-057~~ 08-03.00-057.00
83-101-01 CONTRACT NO.	ROUTE 7, MILL CREEK TO NORTH OF ROUTE 72 PROJECT TITLE	
27-R CONTRACT PROJECT NO.	1812-129 DEED RECORD	SEPT. 23, 1994 DEED DATE
SCALE 1" = 40'		~~1.352~~ +/- AC. AREA OF EXCESS
DESIGNING		1.347

STATE OF DELAWARE
DEPARTMENT OF TRANSPORTATION
OFFICE OF PRECONSTRUCTION
P.O. BOX 778
DOVER, DELAWARE 19903

REAL ESTATE SECTION

DRAWN BY J. MORI DATE 2/21/96 PLOT DWG. NO. | NC | 497