SOUTH PILE PROFILE ASBUILT

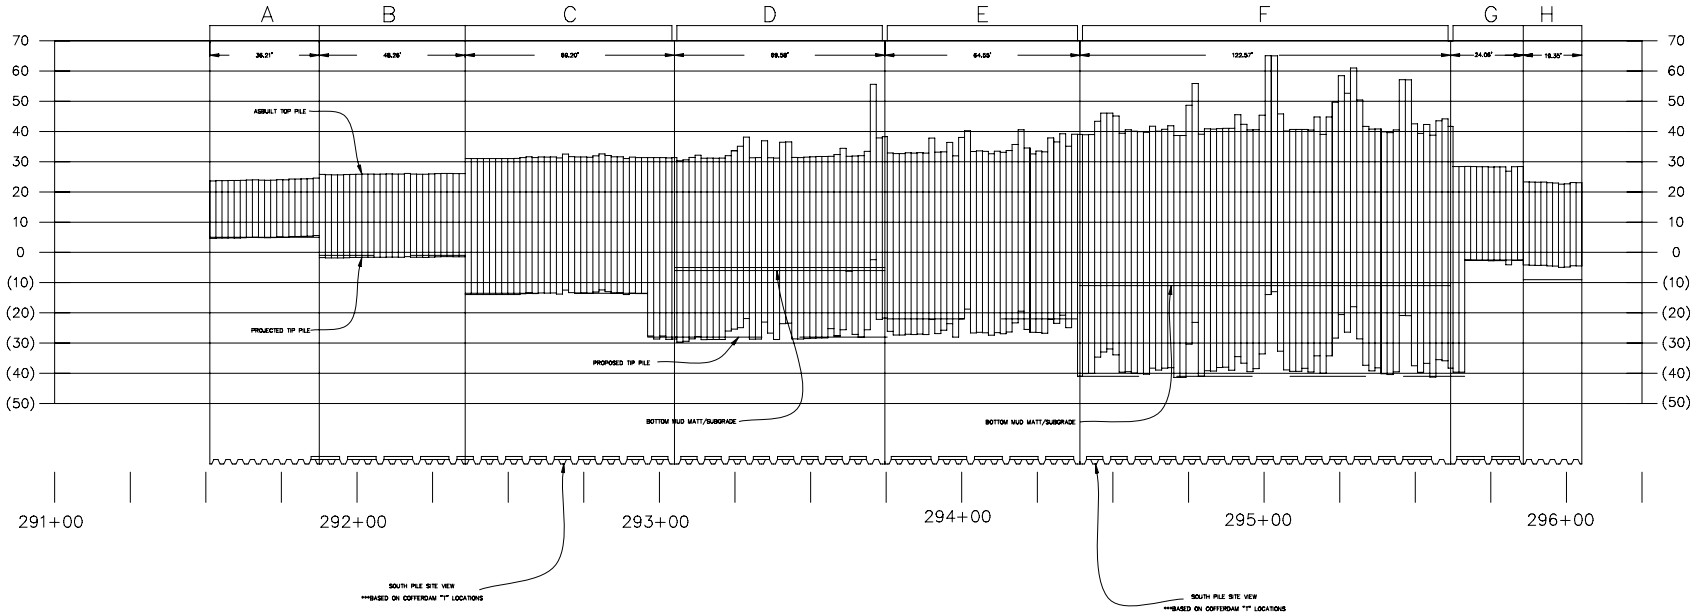

DATE	REVISION

PROJ. MGR.	DM
SURVEY	MMD/AD
DRAWN	MMD
CHECKED	JV

INDIAN RIVER INLET BRIDGE
SOUTH PILE ASBUILT

DRAWING NO.	SCALE	DATE	SHEET NO.
2005101.01	1"=20'	09-07-05	1

GPI
GREENMAN-PEDERSEN, INC.
ENGINEERS, ARCHITECTS, PLANNERS, CONSTRUCTION ENGINEERS & INSPECTORS
10630 GUILFORD ROAD, SUITE 100 JESSUP, MD 20794
WASH. (301) 470-2772 BALT. (410) 880-3055
FAX: (301) 490-2649 www.gpinc.com

FN
AX