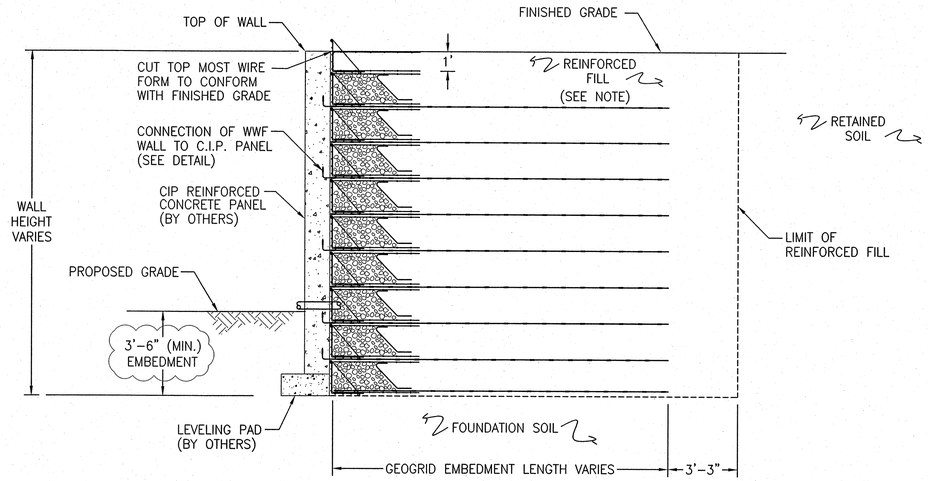

TYPICAL CROSS-SECTION - WALL 3

NOTES:
1. REINFORCED FILL FROM BOTTOM OF WIRE WALL UP TO EL. 12.0 SHALL BE No. 57 STONE OR OTHER SUITABLE FREE-DRAINING MATERIAL. SUFFICIENT ADDITIONAL STONE SHALL BE INSTALLED SUCH THAT THE FINAL TOP ELEVATION OF STONE IS AT LEAST EL. 12.0 AFTER SETTLEMENT HAS OCCURRED.

2. SEE WELDED WIRE WALL FACE DETAILS ON SHEET 26 OF 28 FOR FACING DETAIL.

2/8/06

THIS DESIGN IS BASED UPON SPECIFIC PROPERTIES OF TENSAR PRODUCTS (GEOGRIDS, DRAINAGE COMPOSITES AND EROSION MEDIA), WHICH ARE PROPRIETARY TO THE TENSAR CORPORATION 1210 CITIZENS PARKWAY, MORROW GA. 30260. ANY SUBSTITUTION OF THE SPECIFIED PRODUCTS WILL INVALIDATE THIS DESIGN. THIS DRAWING IS BEING FURNISHED FOR USE ON THIS SPECIFIC PROJECT ONLY. ANY PARTY ACCEPTING THIS DOCUMENT DOES SO IN CONFIDENCE AND AGREES THAT IT SHALL NOT BE DUPLICATED WHOLE OR IN PART, NOR DISCLOSED TO OTHERS, WITHOUT THE CONSENT OF TENSAR EARTH TECHNOLOGIES, INC.

COPYRIGHT 2005, TENSAR EARTH TECHNOLOGIES, INC.

Tensar®
Tensar Earth Technologies, Inc.
5883 Glenridge Drive, Suite 200
Atlanta, Georgia 30328
(404) 250-1290

REVISIONS \ ISSUE

1	12/15/04	NO CHANGE
2	1/26/05	NO CHANGE
3	2/10/05	ADDENDUM No. 1
4	8/12/05	ISSUED FOR REVIEW - FINAL DESIGN
5	9/9/05	NO CHANGE
6	10/31/05	NO CHANGE
7	2/8/06	ISSUED FOR CONSTRUCTION

Project Number N04513
File Name N0451323.DWG
Date Drawn 9/28/04
Scale As Shown
Designed by CV/WL
Drawn by JMR
Checked by

INDIAN RIVER INLET
MSE WALLS
SUSSEX COUNTY. DELAWARE

ELEVATION VIEW
WALL 3

Sheet Number
23 of 28